

JANSSON SHUPE & MUNGER LTD.

INTELLECTUAL PROPERTY LAW

PETER N. JANSSON
JOHN E. MUNGER
RICHARD W. WHITE*
MOLLY HOGAN MCKINLEY
JULIE F. KIRBY*
STEVEN M. SHUPE**
LARRY L. SHUPE (OF COUNSEL)
EDWARD R. ANTARAMIAN (OF COUNSEL)

* NOT ADMITTED IN ILLINOIS
** NOT ADMITTED IN WISCONSIN

WWW.JANLAW.COM

REPLY TO:

WISCONSIN OFFICE

245 MAIN STREET
RACINE, WI 53403
PHONE: 262/632-6900
FAX: 262/632-2257

ILLINOIS OFFICE

207 EAST WESTMINSTER
LAKE FOREST, IL 60045
PHONE: 847/283-0900
FAX: 847/283-0901

Facsimile Cover Sheet**To:**Name: Mr. Lewis/Certificate of Correction BranchFirm: United States Patent & Trademark OfficeFax No. 703/308-6672Date: November 18, 2008**From:**Name: ChrisPages: 27Fax No. (262) 632-2257

If transmission is impaired, please call (262) 632-6900.

Confirmation Will Not Follow by Mail**Message:**

This facsimile is intended only for the individual to whom it is addressed and may contain information that is privileged, confidential or exempt from disclosure under applicable law. If you have received this facsimile in error, please notify us immediately by telephone (collect), and return the original message to us at the above address via the U.S. Postal Service.


INTELLECTUAL PROPERTY LAW AND LITIGATION
PATENTS • TRADEMARKS • COPYRIGHTS


PTO/SB/21 (08-08)

Approved for use through 09/30/2008. OMB 0651-0031
U.S. Patent and Trademark Office: U.S. DEPARTMENT OF COMMERCE

Under the Paperwork Reduction Act of 1995, no persons are required to respond to a collection of information unless it displays a valid OMB control number.

TRANSMITTAL FORM (to be used for all correspondence after initial filing)	Application Number	08/705,326
	Filing Date	08/29/1996
	First Named Inventor	LaCount et al.
	Art Unit	
	Examiner Name	Eugenia Jones
Total Number of Pages in This Submission		Attorney Docket Number ALW-113REX

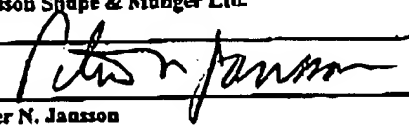ENCLOSURES (Check all that apply)		
<input type="checkbox"/> Fee Transmittal Form <input type="checkbox"/> Fee Attached <input type="checkbox"/> Amendment / Reply <input type="checkbox"/> After Final <input type="checkbox"/> Affidavits/declaration(s) <input type="checkbox"/> Extension of Time Request <input type="checkbox"/> Express Abandonment Request <input type="checkbox"/> Information Disclosure Statement <input type="checkbox"/> Certified Copy of Priority Document(s) <input type="checkbox"/> Reply to Missing Parts/Incomplete Application <input type="checkbox"/> Reply to Missing Parts under 37 CFR 1.52 or 1.53	<input type="checkbox"/> Drawing(s) <input type="checkbox"/> Licensing-related Papers <input type="checkbox"/> Petition <input type="checkbox"/> Petition to Convert to a Provisional Application <input checked="" type="checkbox"/> Power of Attorney, Revocation Change of Correspondence Address <input type="checkbox"/> Terminal Disclaimer <input type="checkbox"/> Request for Refund <input type="checkbox"/> CD, Number of CD(s) _____ <input type="checkbox"/> Landscape Table on CD	<input type="checkbox"/> After Allowance Communication to TC <input type="checkbox"/> Appeal Communication to Board of Appeals and Interferences <input type="checkbox"/> Appeal Communication to TC (Appeal Notice, Brief, Reply Brief) <input type="checkbox"/> Proprietary Information <input type="checkbox"/> Status Letter <input checked="" type="checkbox"/> Other Enclosure(s) (please identify below): Petition for Certificate of Correction Proposed Certificate of Correction Four (4) Sheets of Red-Lined Drawings
Remarks		
SIGNATURE OF APPLICANT, ATTORNEY, OR AGENT		
Firm Name	Jansson Shupe & Munger Ltd.	
Signature		
Printed name	Peter N. Jansson	
Date	October 17, 2008	Reg. No. 26,185

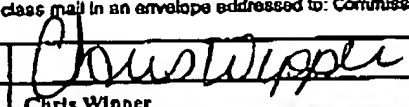CERTIFICATE OF TRANSMISSION/MAILING			
I hereby certify that this correspondence is being facsimile transmitted to the USPTO or deposited with the United States Postal Service with sufficient postage as first class mail in an envelope addressed to: Commissioner for Patents, P.O. Box 1450, Alexandria, VA 22313-1450 on the date shown below:			
Signature			
Typed or printed name	Chris Wipper	Date	October 17, 2008

This collection of information is required by 37 CFR 1.5. The information is required to obtain or retain a benefit by the public which is to file (and by the USPTO to process) an application. Confidentiality is governed by 35 U.S.C. 122 and 37 CFR 1.11 and 1.14. This collection is estimated to 2 hours to complete, including gathering, preparing, and submitting the completed application form to the USPTO. Time will vary depending upon the individual case. Any comments on the amount of time you require to complete this form and/or suggestions for reducing this burden, should be sent to the Chief Information Officer, U.S. Patent and Trademark Office, U.S. Department of Commerce, P.O. Box 1450, Alexandria, VA 22313-1450. DO NOT SEND FEES OR COMPLETED FORMS TO THIS ADDRESS. SEND TO: Commissioner for Patents, P.O. Box 1450, Alexandria, VA 22313-1450.

If you need assistance in completing the form, call 1-800-PTO-9199 and select option 2.

POWER OF ATTORNEY

Alwin Manufacturing Company, Inc., a Wisconsin corporation, at 1206 Velp Avenue, Green Bay, Wisconsin, 54306, owner of U.S. Patent Nos. 6,032,898 filed August 29, 1996, assignment recorded at Reel 8199, frame 0758, hereby:

- Revokes all previous powers of attorney; and
- Appoints the following attorneys to transact all business in the Patent & Trademark Office connected with such patent and to receive any and all communications related to such patent:

Peter N. Jansson, Registration No. 26,185
John E. Munger, Registration No. 37,685
Richard W. White, Registration No. 50,601
Molly Hogan McKinley, Registration No. 59,581
Julie F. Kirby, Registration No. 58,048
Steven M. Shape, Registration No. 30802

all of whom are at the following address and have the following telephone numbers:

Jansson Shupe & Munger Ltd.
245 Main Street, Suite M
Racine, WI 53403-1034

Telephone: 262/632-6900
Telefax: 262/632-2257

All further communications should be directed to John E. Munger.

ALWIN MANUFACTURING COMPANY, INC.

By 
Sigurd S. Witt, Vice President

Date 10/17/08

PATENT

IN THE UNITED STATES PATENT AND TRADEMARK OFFICE

In re Patent No. 6,032,898

Inventors: Kenneth H. LaCount et al.

Attorney Docket No. ALW-113REX

Assignee: Alwin Manufacturing Co.

Examiner: Eugenia Jones

Issued: March 7, 2000

Serial No. 08/705,326

Filed: August 29, 1996

Title: MULTIPLE ROLL TOWEL DISPENSER

**PETITION FOR CERTIFICATE OF CORRECTION
PURSUANT TO 37 C.F.R. §§ 1.322 and 1.323**

Attn: Certificate of Correction Branch
Commissioner for Patents
P.O. Box 1450
Alexandria, VA 22313-1450

Sir:

Petitioner, pursuant to 37 C.F.R. §§ 1.322 and 1.323, petitions for issuance of a
Certificate of Correction to United States Patent No. 6,032,898, issued on March 7, 2000.

Petitioner requests that a Certificate of Correction be issued correcting the following
errors:

In the drawings, sheet 1, Fig. 2, reference numeral "22" on the sidewall of outwardly
extending flange 24 should be deleted and reference numeral --27-- should be applied to the
stamped portion;

In the drawings, sheet 1, Fig. 2, reference numeral --43-- should be applied to the left-
hand side hub of the paper roll holder assembly 40; reference numeral --58-- should be applied to

In re Patent No. 6,032,898
Inventors: Kenneth H. LaCount et al.

Page 2 of 6

the rear wall of the chassis 55; reference numeral --57-- should be applied to the left-hand side spaced parallel side wall of chassis 55; reference numeral --38-- should be applied to the clip extending from the rear wall 32 of the housing 21.

In the drawings, sheet 1, Fig. 2, reference numeral --121-- should be applied to the drive roller segments of the drive roller 120.

In the drawings, sheet 1, Fig. 2, reference numeral --105-- should be applied to the transfer roller assembly; reference numeral --106-- should be applied to the shaft 106 of the transfer roller assembly 105; reference numeral --110-- should be applied to the transfer mechanism; reference numeral --112-- should be applied to the indented or removed portion of the cylindrical portion 111 of the shaft 106; reference numeral --115-- should be applied to the snap clip which receives the indented or removed portion 112 of the cylindrical portion 111 of the shaft 106.

In the drawings, sheet 3, Fig. 6, the reference numeral "50" (not the reference numeral "50" pointing to the cover) should be deleted and reference numeral --51-- should be applied to the front panel of the cover 50.

In the drawings, sheet 4, Fig. 10, the reference numeral "131" pointing to the free end of the flight of paper 131 should be deleted and the reference numeral --132-- should be applied to the free end of the flight of paper 131.

In the drawings, sheet 5, Fig. 11, reference numeral --105-- should be applied to the transfer roller assembly; reference numeral --107-- should be applied to the journal on the right-hand end of the transfer roller assembly 105; reference numeral --108-- should be applied to the

In re Patent No. 6,032,898
Inventors: Kenneth H. LaCount et al.

Page 3 of 6

journal on the left-hand end of the transfer roller assembly 105; reference numeral --109-- should be applied to the stop plate on journal 108; and reference numeral --110-- should be applied to the transfer mechanism positioned generally centrally of the shaft of the transfer roller assembly 105.

In the drawings, sheet 5, Fig. 12, reference numeral --105-- should be applied to the transfer roller assembly; reference numeral --106-- should be applied to the shaft of the transfer roller assembly 105; reference numeral --107-- should be applied to the journal on the right-hand end of the transfer roller assembly 105; reference numeral --108-- should be applied to the journal on the left-hand end of the transfer roller assembly 105; reference numeral --110-- should be applied to the transfer mechanism positioned generally centrally of the shaft 106; and reference numeral --111-- should be applied to cylindrical portion of the shaft 106.

In the drawings, sheet 5, Fig. 13, reference numeral --105-- should be applied to the transfer roller assembly; and reference numeral --106-- should be applied to the shaft of the transfer roller assembly.

In the drawings, sheet 5, Fig. 14, reference numeral --105-- should be applied to the transfer roller assembly; reference numeral --106-- should be applied to the shaft of the transfer roller assembly 105; reference numeral --110-- should be applied to the transfer mechanism positioned generally centrally of the shaft 106; and reference numeral --112-- should be applied to the indented or removed portion of the cylindrical portion 111 of the shaft 106.

In the drawings, sheet 5, Fig. 15, reference numeral --105-- should be applied to the transfer roller assembly; and reference numeral --116-- should be applied to the groove or

In re Patent No. 6,032,898
Inventors: Kenneth H. LaCount et al.

Page 4 of 6

receptacle of the cylindrical portion 111 of the shaft 106.

In the drawings, sheet 5, Fig. 16, reference numeral --95-- should be applied to the tear bar, reference numeral --95a-- should be applied to the tabs of the tear bar 95; reference numeral --95b-- should be applied to the clips of the tear bar 95; reference numeral --95c-- should be applied to the serrated edge of the tear bar 95; and section line 17--17 should be added at the middle portion of the drawing at the top and bottom thereof.

In column 1, line 41, after "pressure" insert --(i.e., force)--.

In column 1, line 42, after 3, delete "psi" and insert --lbf--.

In column 1, line 42, after 5, delete "psi" and insert --lbf--.

In column 3, line 54, delete "44" and insert --22--.

In column 4, line 37, delete "121".

In column 6, line 34, delete "roller" and insert --roller segments--.

In column 6, line 51, after "inserted" insert --under--.

In column 6, line 58, delete "rollers" and insert --roller segments--.

In column 6, line 65, delete "121" and insert --21--.

In column 8, claim 1, line 28, after "mounted on said housing" insert --,-.

In column 8, claim 1, line 32, delete "operating" and insert --operates--.

In column 8, claim 3, line 45, delete "psi" and insert --pounds force--.

In column 8, claim 4, line 48, delete "complimentary" and insert --complementary--.

In re Patent No. 6,032,898
Inventors: Kenneth H. LaCount et al.

Page 5 of 6

Remarks

This Petition for Certificate of Correction is made pursuant to 37 CFR §1.322 and 1.323. The Petition requests corrections in spelling, punctuation, verb form, units terminology and certain numbers (or missing numbers) in ten of the figures. All corrections are in keeping with what is understood by persons in the art based on the content of the patent as issued. All corrections requested are supported by the specification, drawings and claims of the '898 Patent and do not add any new matter or broaden the disclosure or claims of the '898 Patent.

Regarding the insertion of "pounds force" for "psi" in claim 3 and elsewhere, claim 3 itself speaks of "force," and the force unit is, of course, "pounds force." The correction to "pounds force" is not only fully consistent with the use of the term "force" in claim 3, but is also consistent with the twice referenced ADA (Americans with Disabilities Act of 1990) standard (mentioned at col. 1, lines 22-24 and at col. 1, lines 38-41)¹ which, as is well known to those in the art, refers to pounds force (abbreviated "lbf") as the unit of measure.

Regarding the figures, petitioner has submitted herewith a red-line version of the figures requiring correction and replacement sheets for those figures. Additions to the figures are shown in red and are circled. Deletions are in red and are marked with an "X." Regarding Figures 2 and 11-17, the figures as filed included numerous part numbers which were not shown in the issued patent. Figures 6 and 10 have been amended to correct a reference number, as noted. Such changes do not constitute new matter.

¹As known in the art, section 4.27.4 of the ADA guidelines, in pertinent part, states as follows: "The force required to activate controls shall be no greater than 5 lbf" (emphasis added)


In re Patent No. 6,032,898
Inventors: Kenneth H. LaCount et al.

Page 6 of 6

A copy of a proposed Certificate of Correction is enclosed herewith. Given that some of the errors were made by applicants, it is understood that the fee for this petition is \$100. Please charge Deposit Account No. 10-0270 for the filing fee of \$100; if this sum is incorrect, please debit or credit this Deposit Account with the difference.

Dated: October 17, 2008

Respectfully submitted,

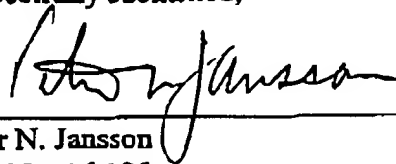

Peter N. Jansson
Reg. No. 26,185

Jansson Shupe & Munger Ltd.
245 Main Street
Racine, WI 53403-1034
(262) 632-6900
Atty. Docket No.: ALW-113REX

CERTIFICATE OF MAILING

I hereby certify that this correspondence is being deposited with the United States Postal Service as first class mail, with sufficient postage, in an envelope addressed to: ~~MAIL STOP~~

COMMISSIONER FOR PATENTS, ALEXANDRIA, VA 22313-1450 on

10/17/08
Christine M. Wipper

Name

Signature

Date

Christine Wipper 10/17/08

(Also Form PTO-1050)

UNITED STATES PATENT AND TRADEMARK OFFICE CERTIFICATE OF CORRECTION

PATENT NO. : 6,032,898

DATED : March 7, 2000

INVENTOR(S) : LaCount et al.

It is certified that an error appears or errors appear in the above-identified patent and that said Letters Patent is hereby corrected as shown below:

In the drawings, sheet 1, Fig. 2, reference numeral "22" on the sidewall of outwardly extending flange 24 should be deleted and reference numeral —27— should be applied to the stamped portion;

In the drawings, sheet 1, Fig. 2, reference numeral —43— should be applied to the left-hand side hub of the paper roll holder assembly 40; reference numeral —58— should be applied to the rear wall of the chassis 55; reference numeral —57— should be applied to the left-hand side spaced parallel side wall of chassis 55; reference numeral —38— should be applied to the clip extending from the rear wall 32 of the housing 21.

In the drawings, sheet 1, Fig. 2, reference numeral —121— should be applied to the drive roller segments of the drive roller 120.

In the drawings, sheet 1, Fig. 2, reference numeral —105— should be applied to the transfer roller assembly; reference numeral —106— should be applied to the shaft 106 of the transfer roller assembly 105; reference numeral —110— should be applied to the transfer mechanism; reference numeral —112— should be applied to the indented or removed portion of the cylindrical portion 111 of the shaft 106; reference numeral —115— should be applied to the snap clip which receives the indented or removed portion 112 of the cylindrical portion 111 of the shaft 106.

MAILING ADDRESS OF SENDER (Please do not use customer number)

Jansson Shupe & Munger Ltd.
245 Main Street
Racine, WI 53403
262/632-6900

PATENT NO. 6,032,898

No. of additional copies



(Also Form PTO-1050)


UNITED STATES PATENT AND TRADEMARK OFFICE CERTIFICATE OF CORRECTION

PATENT NO. : 6,032,898

DATED : March 7, 2000

INVENTOR(S) : LaCount et al.

It is certified that an error appears or errors appear in the above-identified patent and that said Letters Patent is hereby corrected as shown below:

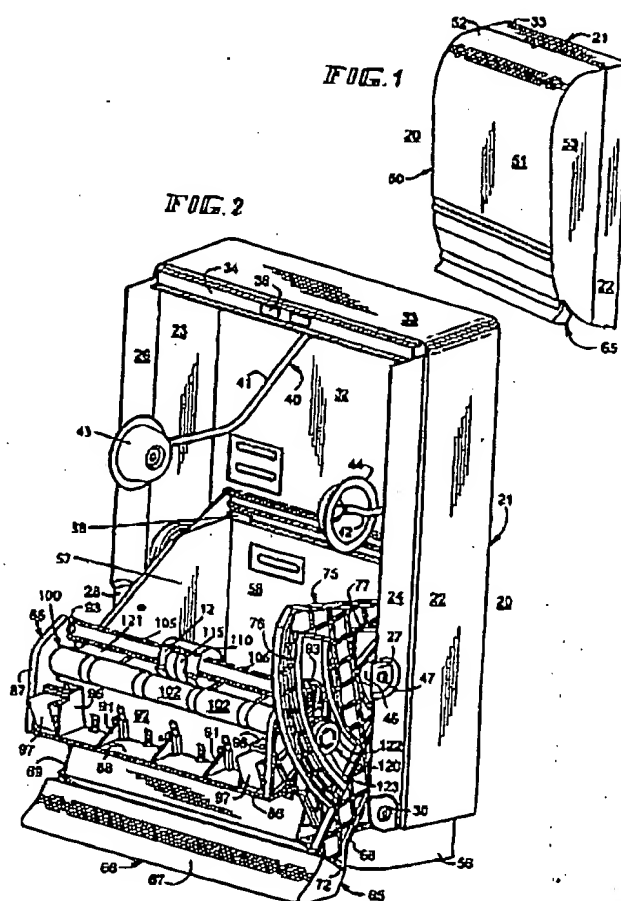

MAILING ADDRESS OF SENDER (Please do not use customer number

Jansson Shupe & Munger Ltd.
245 Main Street
Racine, WI 53403
262/632-6900

PATENT NO. 6,032,898

No. of additional copies



(Also Form PTO-1050)

UNITED STATES PATENT AND TRADEMARK OFFICE CERTIFICATE OF CORRECTION

PATENT NO. : 6,032,898

DATED : March 7, 2000

INVENTOR(S) : LaCount et al.

It is certified that an error appears or errors appear in the above-identified patent and that said Letters Patent is hereby corrected as shown below:

In the drawings, sheet 3, Fig. 6, the reference numeral "50" (not the reference numeral "50" pointing to the cover) should be deleted and reference numeral -51- should be applied to the front panel of the cover 50.

MAILING ADDRESS OF SENDER (Please do not use customer number)

Jansson Shupe & Munger Ltd.
245 Main Street
Racine, WI 53403
262/632-6900

PATENT NO. 6,032,898

No. of additional copies



(Also Form PTO-1050)


UNITED STATES PATENT AND TRADEMARK OFFICE CERTIFICATE OF CORRECTION

PATENT NO. : 6,032,898

DATED : March 7, 2000

INVENTOR(S) : LaCount et al.

It is certified that an error appears or errors appear in the above-identified patent and that said Letters Patent is hereby corrected as shown below:

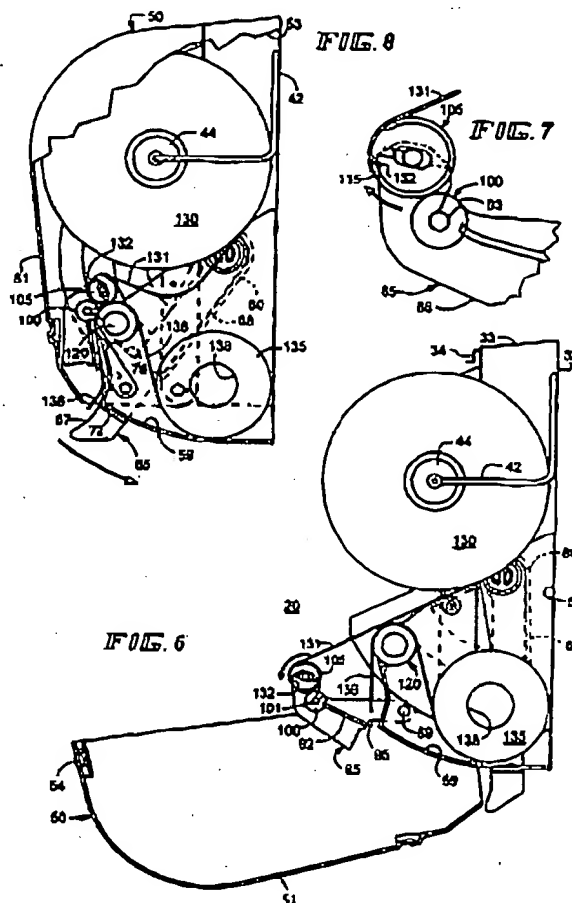

PATENT NO. 6,032,898

Jansson Shupe & Munger Ltd.
245 Main Street
Racine, WI 53403
262/632-6900

No. of additional copies



(Also Form PTO-1050)

**UNITED STATES PATENT AND TRADEMARK OFFICE
CERTIFICATE OF CORRECTION**

PATENT NO. : 6,032,898

DATED : March 7, 2000

INVENTOR(S) : LaCount et al.

It is certified that an error appears or errors appear in the above-identified patent and that said Letters Patent is hereby corrected as shown below:

In the drawings, sheet 4, Fig. 10, the reference numeral "131" pointing to the free end of the flit of paper 131 should be deleted and the reference numeral -132- should be applied to the free end of the flit of paper 131.

MAILING ADDRESS OF SENDER (Please do not use customer number)

Jansson Shupe & Munger Ltd.
245 Main Street
Racine, WI 53403
262/632-6900

PATENT NO. 6,032,898

No. of additional copies



(Also Form PTO-1050)


UNITED STATES PATENT AND TRADEMARK OFFICE CERTIFICATE OF CORRECTION

PATENT NO. : 6,032,898

DATED : March 7, 2000

INVENTOR(S) : LaCount et al.

It is certified that an error appears or errors appear in the above-identified patent and that said Letters Patent is hereby corrected as shown below:

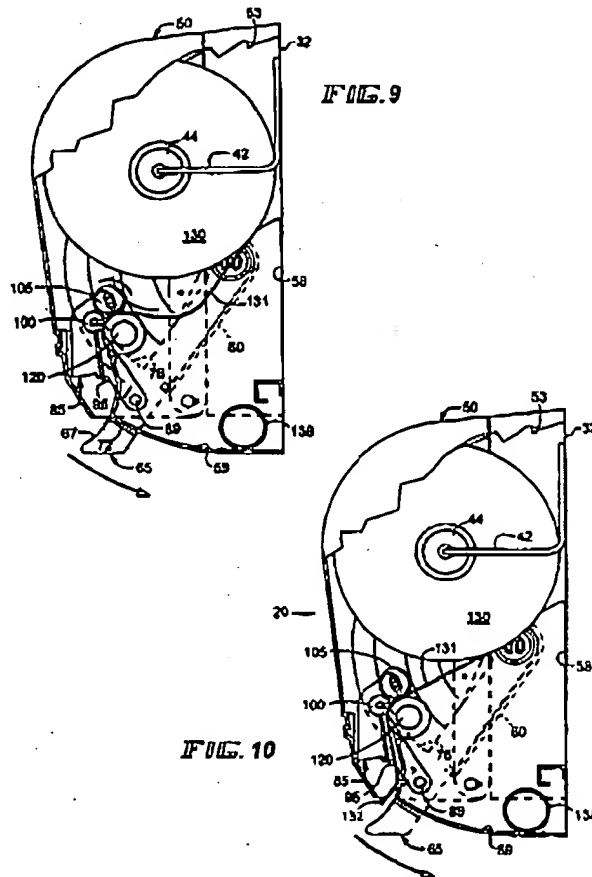

MAILING ADDRESS OF SENDER (Please do not use customer number

PATENT NO. 6,032,898

Jansson Shupe & Munger Ltd.
245 Main Street
Racine, WI 53403
262/632-6900

No. of additional copies



(Also Form PTO-1050)

UNITED STATES PATENT AND TRADEMARK OFFICE

CERTIFICATE OF CORRECTION

PATENT NO. : 6,032,898

DATED : March 7, 2000

INVENTOR(S) : LaCount et al.

It is certified that an error appears or errors appear in the above-identified patent and that said Letters Patent is hereby corrected as shown below:

In the drawings, sheet 5, Fig. 11, reference numeral ~~105~~ should be applied to the transfer roller assembly; reference numeral ~~107~~ should be applied to the journal on the right-hand end of the transfer roller assembly 105; reference numeral ~~108~~ should be applied to the journal on the left-hand end of the transfer roller assembly 105; reference numeral ~~109~~ should be applied to the stop plate on journal 108; and reference numeral ~~110~~ should be applied to the transfer mechanism positioned generally centrally of the shaft of the transfer roller assembly 105.

In the drawings, sheet 5, Fig. 12, reference numeral ~~105~~ should be applied to the transfer roller assembly; reference numeral ~~106~~ should be applied to the shaft of the transfer roller assembly 105; reference numeral ~~107~~ should be applied to the journal on the right-hand end of the transfer roller assembly 105; reference numeral ~~108~~ should be applied to the journal on the left-hand end of the transfer roller assembly 105; reference numeral ~~110~~ should be applied to the transfer mechanism positioned generally centrally of the shaft 106; and reference numeral ~~111~~ should be applied to cylindrical portion of the shaft 106.

In the drawings, sheet 5, Fig. 13, reference numeral ~~105~~ should be applied to the transfer roller assembly; and reference numeral ~~106~~ should be applied to the shaft of the transfer roller assembly.

In the drawings, sheet 5, Fig. 14, reference numeral ~~105~~ should be applied to the transfer roller assembly; reference numeral ~~106~~ should be applied to the shaft of the transfer roller assembly 105; reference numeral ~~110~~ should be applied to the transfer mechanism positioned generally centrally of the shaft 106; and reference numeral ~~112~~ should be applied to the indented or removed portion of the cylindrical portion 111 of the shaft 106.

In the drawings, sheet 5, Fig. 15, reference numeral ~~105~~ should be applied to the transfer roller assembly; and reference numeral ~~116~~ should be applied to the groove or receptacle of the cylindrical portion 111 of the shaft 106.

In the drawings, sheet 5, Fig. 16, reference numeral ~~95~~ should be applied to the tear bar; reference numeral ~~95a~~ should be applied to the tabs of the tear bar 95; reference numeral ~~95b~~ should be applied to the clips of the tear bar 95; reference numeral ~~95c~~ should be applied to the serrated edge of the tear bar 95; and section line 17—17 should be added at the middle portion of the drawing at the top and bottom thereof.

MAILING ADDRESS OF SENDER (Please do not use customer number)

Jansson Shupe & Munger Ltd.
245 Main Street
Racine, WI 53403
262/632-6900

PATENT NO. 6,032,898

No. of additional copies



(Also Form PTO-1050)







UNITED STATES PATENT AND TRADEMARK OFFICE CERTIFICATE OF CORRECTION

PATENT NO. : 6,032,898

DATED : March 7, 2000

INVENTOR(S) : LaCount et al.

It is certified that an error appears or errors appear in the above-identified patent and that said Letters Patent is hereby corrected as shown below:

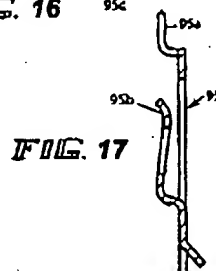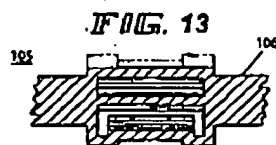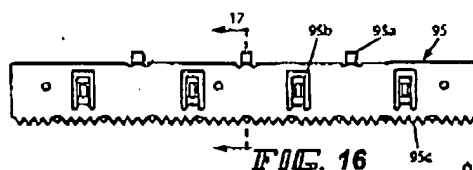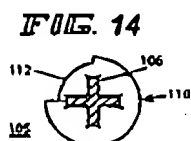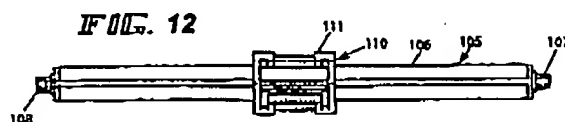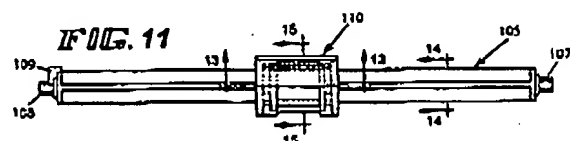

MAILING ADDRESS OF SENDER (Please do not use customer number)

PATENT NO. 6,032,898

Jansson Shupe & Munger Ltd.
245 Main Street
Racine, WI 53403
262/632-6900

No. of additional copies



UNITED STATES PATENT AND TRADEMARK OFFICE

CERTIFICATE OF CORRECTION

PATENT NO. : 6,032,898
 DATED : March 7, 2000
 INVENTOR(S) : LaCount et al.

It is certified that an error appears or errors appear in the above-identified patent and that said Letters Patent is hereby corrected as shown below:

In column 1, line 41, after "pressure" insert ~~—(i.e., force)—~~.

In column 1, line 42, after 3, delete "psi" and insert ~~—lbf—~~.

In column 1, line 42, after 5, delete "psi" and insert ~~—lbf—~~.

In column 3, line 54, delete "44" and insert ~~—22—~~.

In column 4, line 37, delete "121".

In column 6, line 34, delete "roller" and insert ~~—roller segments—~~.

In column 6, line 51, after "inserted" insert ~~—under—~~.

In column 6, line 58, delete "rollers" and insert ~~—roller segments—~~.

In column 6, line 65, delete "121" and insert ~~—21—~~.

In column 8, claim 1, line 28, after "mounted on said housing" insert ~~—,~~.

In column 8, claim 1, line 32, delete "operating" and insert ~~—operates—~~.

In column 8, claim 3, line 45, delete "psi" and insert ~~—pounds force—~~.

In column 8, claim 4, line 48, delete "complimentary" and insert ~~—complementary—~~.

MAILING ADDRESS OF SENDER (Please do not use customer number

Jansson Shupe & Munger Ltd.
 245 Main Street
 Racine, WI 53403
 262/632-6900

PATENT NO. 6,032,898

No. of additional copies



Multiple Roll Towel Dispenser

Inventor: LaCount et al.

U.S. Patent No. 6,032,898

Atty Docket No. ALW-113REX

Red-Lined Version

Replacement Sheet 1 of 4

FIG. 1


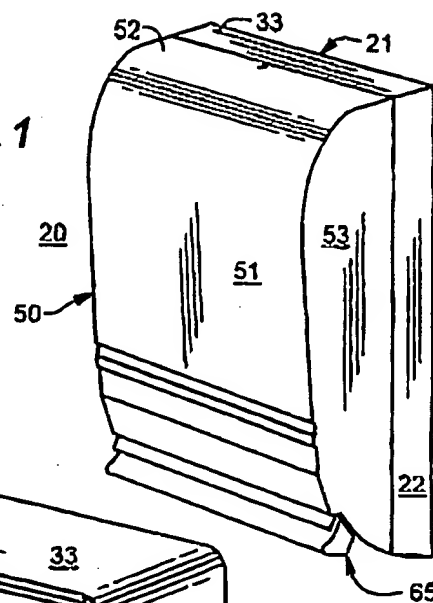


FIG. 2

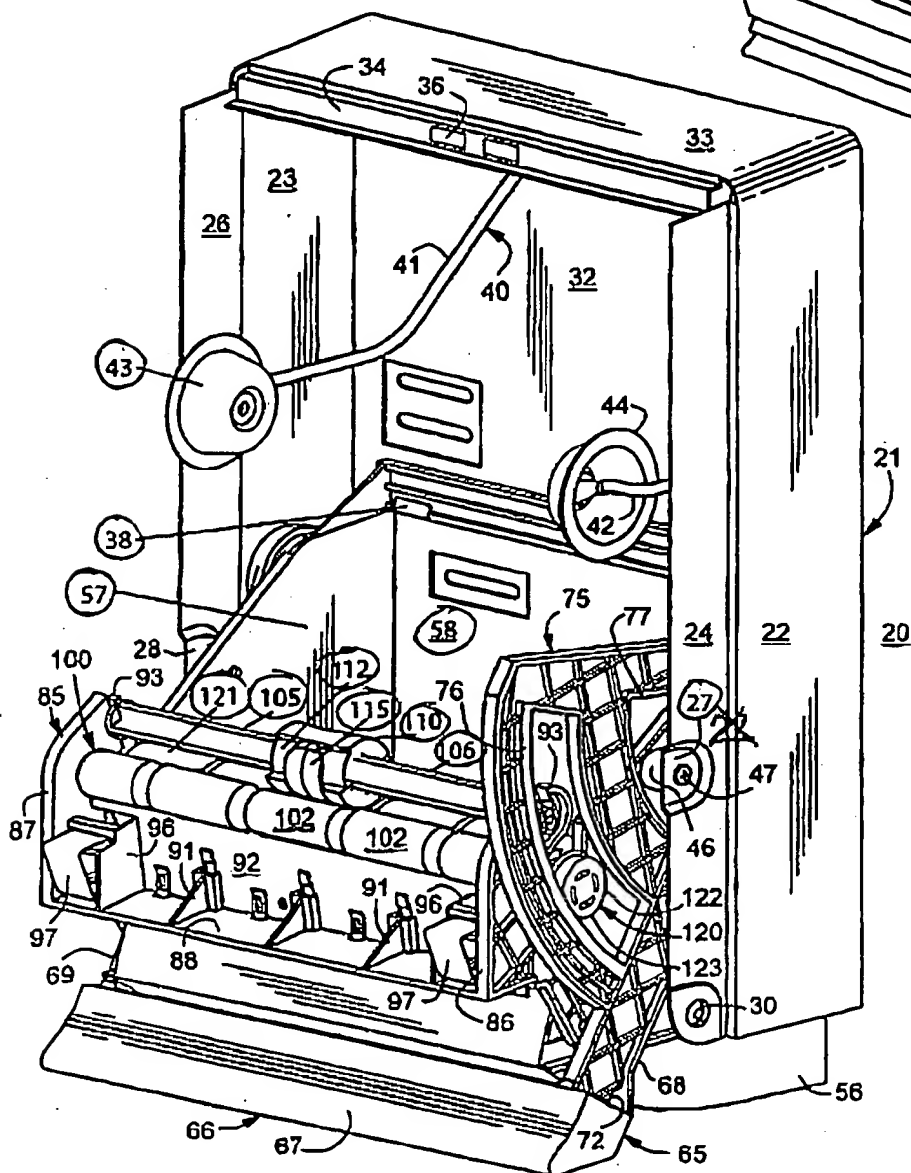

Multiple Roll Towel Dispenser

Inventor: LaCouture et al.

U.S. Patent No. 6,032,898

Atty Docket No. ALW-113REX

Red-Lined Version

Replacement Sheet 2 of 4

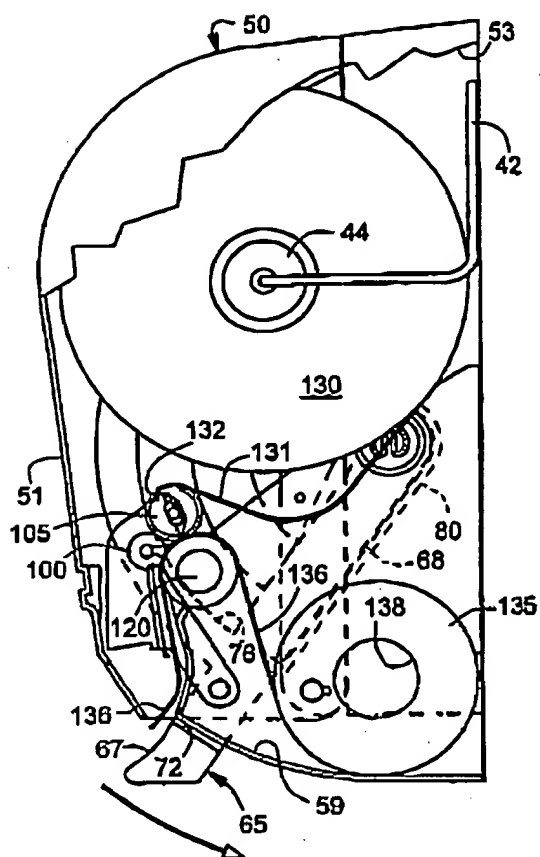


FIG. 8

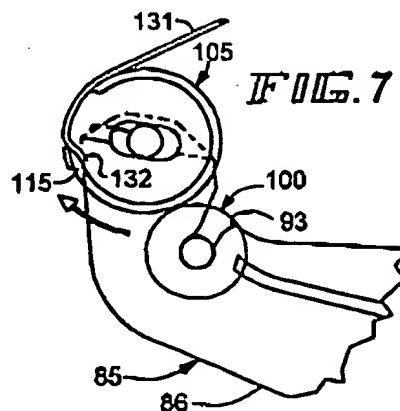


FIG. 7

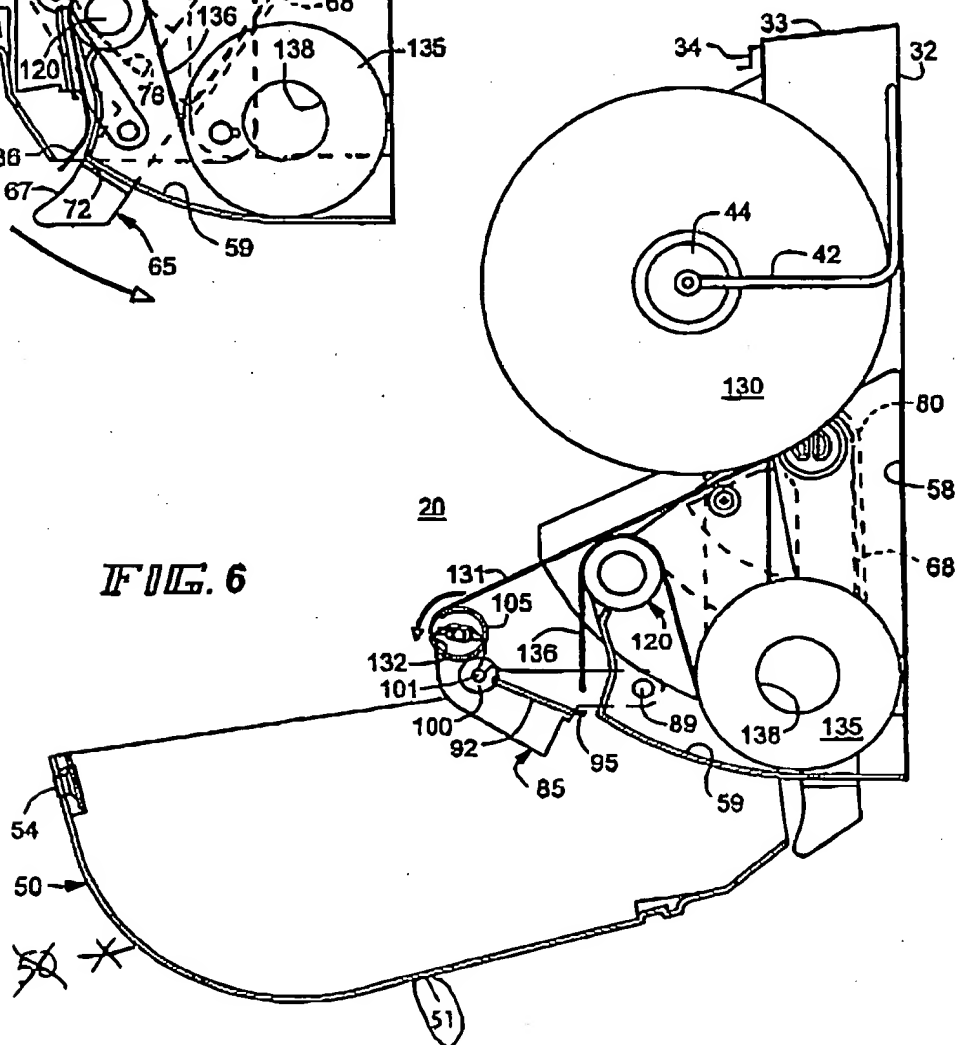


FIG. 6

Multiple Roll Towel Dispenser

Inventor: LaCoutt et al.

U.S. Patent No. 6,032,898

Atty Docket No. ALW-113REX

Red-Lined Version

Replacement Sheet 3 of 4

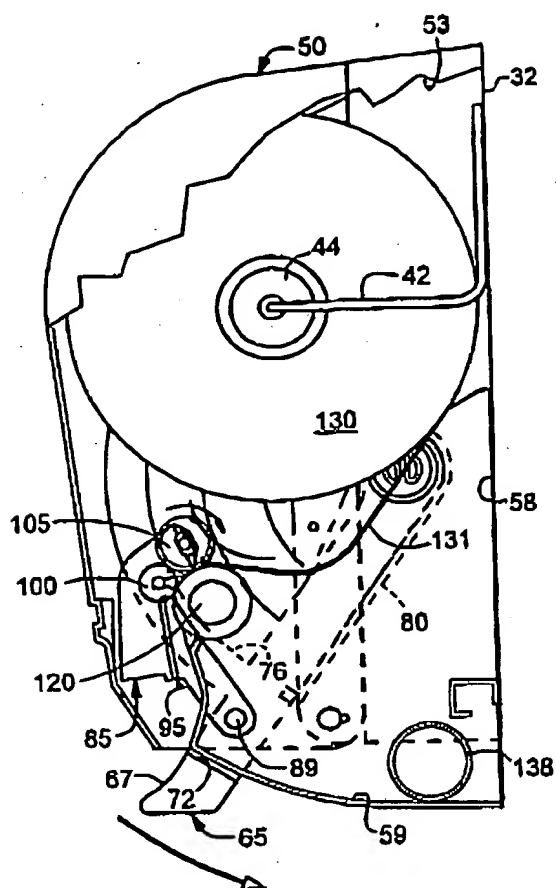


FIG. 9

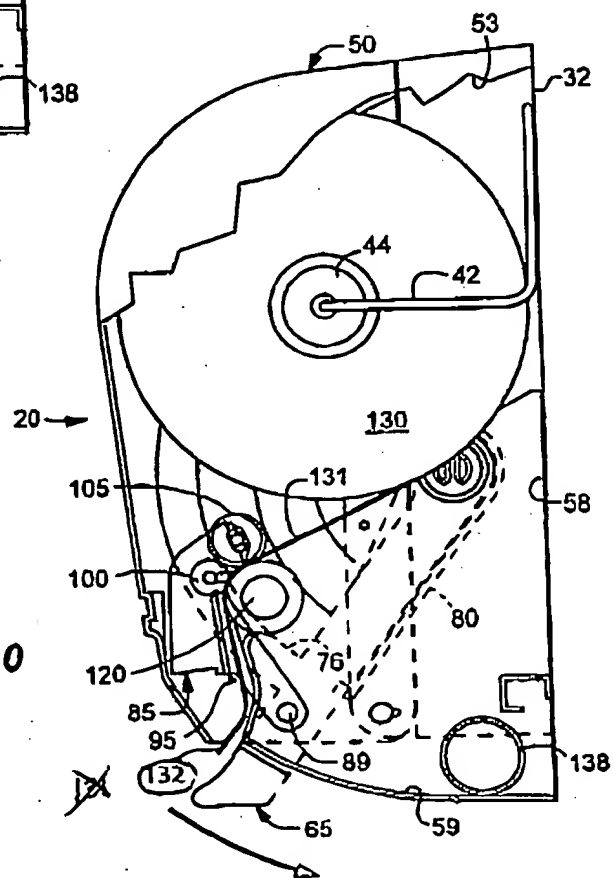


FIG. 10

Multiple Roll Towel Dispenser

Inventor: LaCount et al.

U.S. Patent No. 6,032,898

Atty Docket No. ALW-113REX

Red-Lined Version

Replacement Sheet 4 of 4

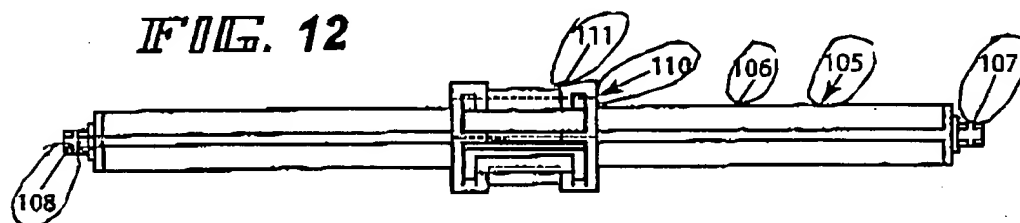
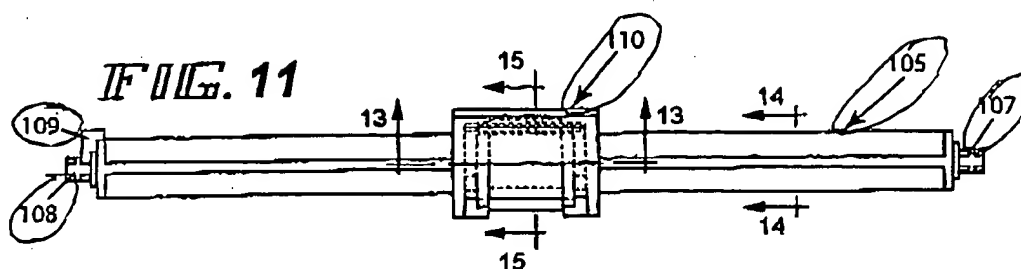


FIG. 14

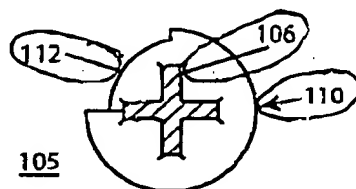


FIG. 15







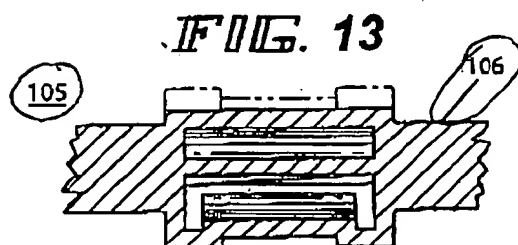


FIG. 17

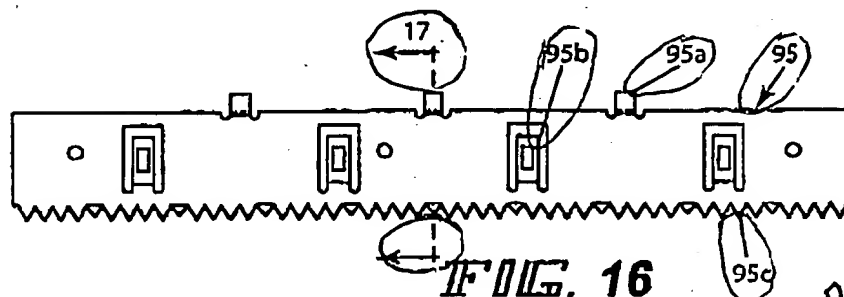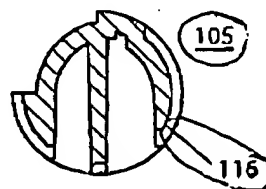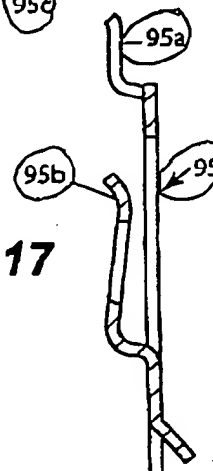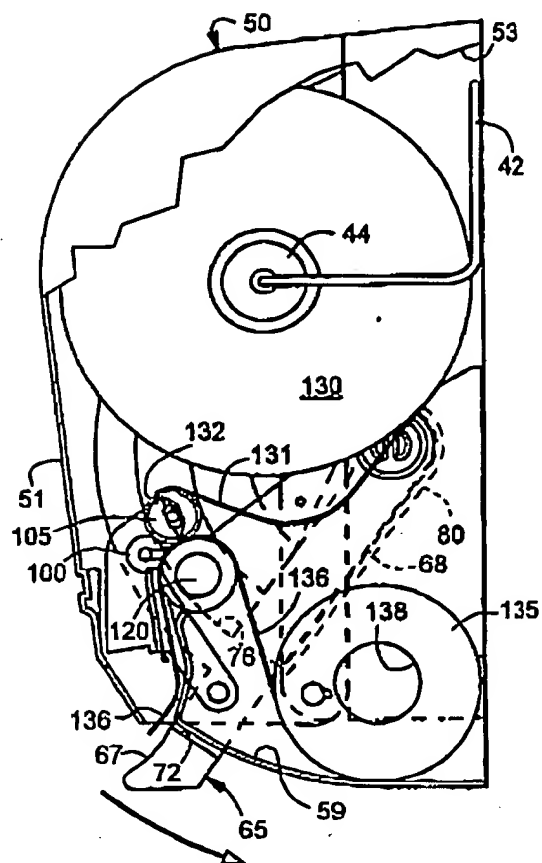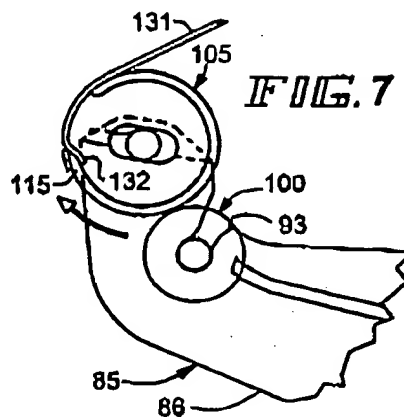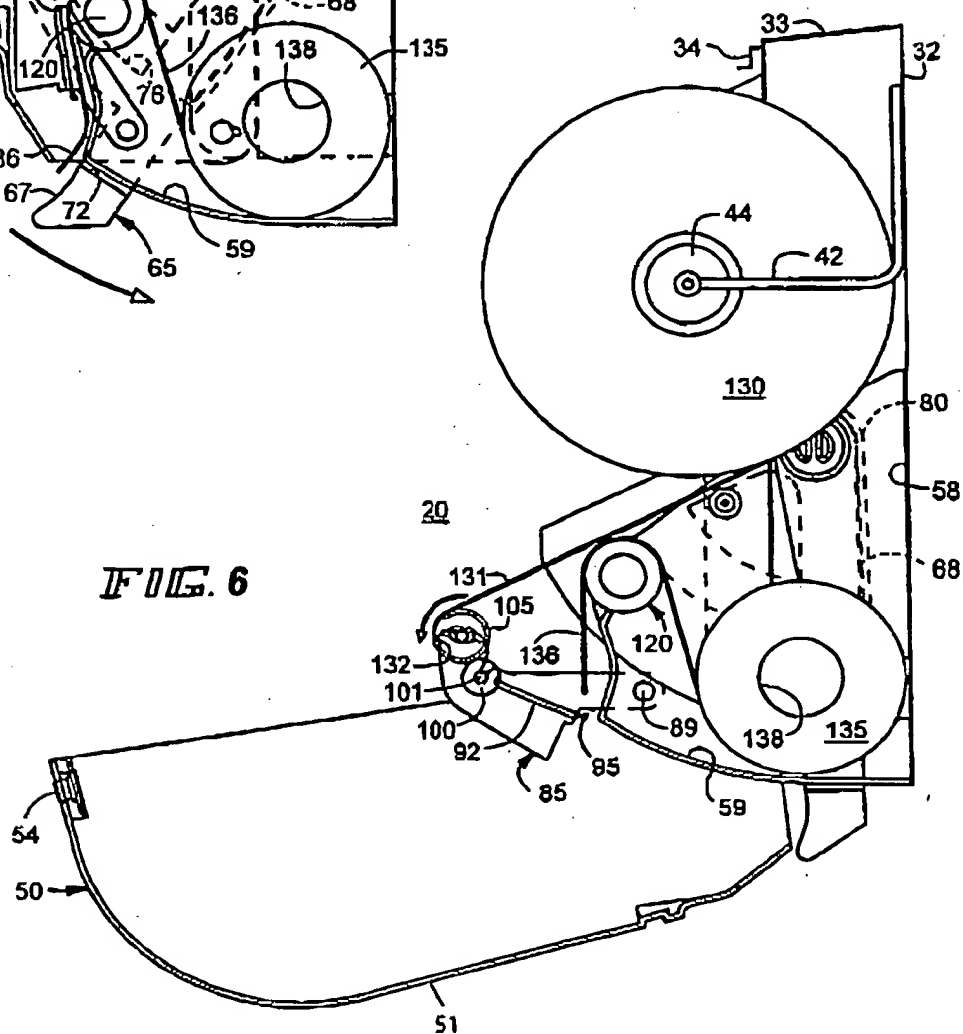

Multiple Roll Towel Dispenser
Inventor: LaCount et al.
U.S. Patent No. 6,032,898
Atty Docket No. ALW-113REX
Replacement Sheet 2 of 4

**FIG. 8****FIG. 7****FIG. 6**

Multiple Roll Towel Dispenser

Inventor: LaCount et al.

U.S. Patent No. 6,032,898

Atty Docket No. ALW-113REX

Replacement Sheet 3 of 4

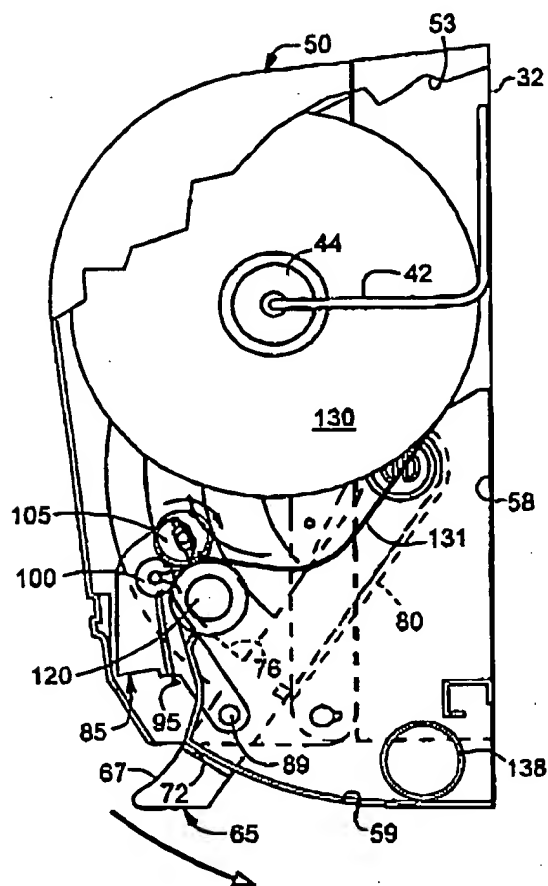


FIG. 9








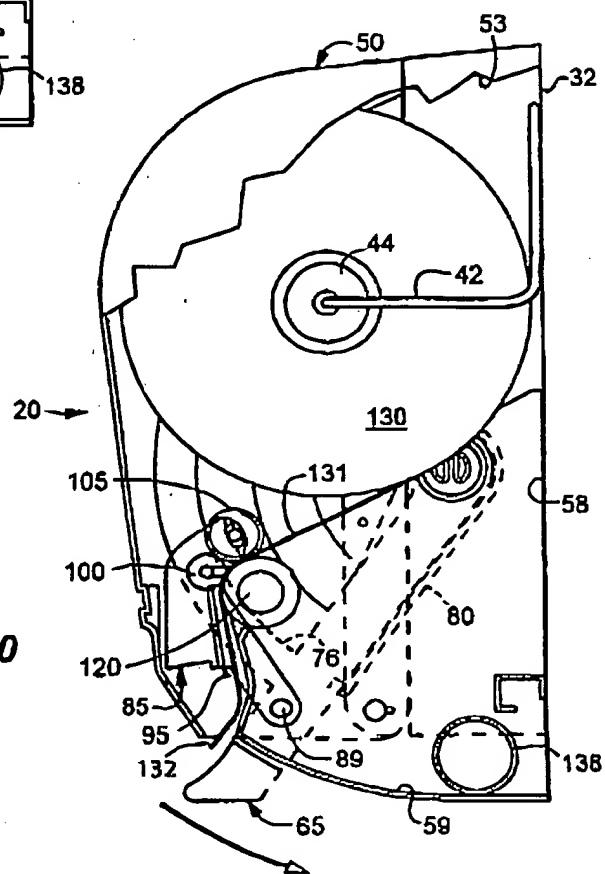


FIG. 10

Multiple Roll Towel Dispenser
Inventor: LaCount et al
U.S. Patent No. 6,052,898
Atty Docket No. ALW-113REX
Replacement Sheet 4 of 4

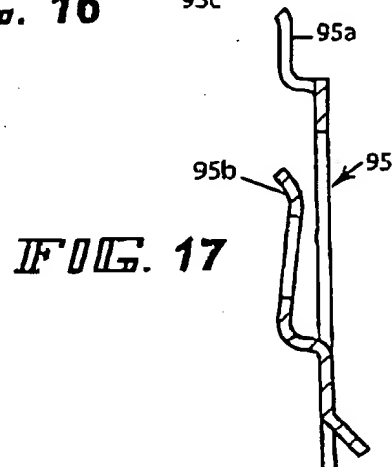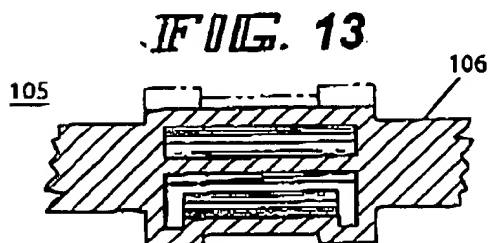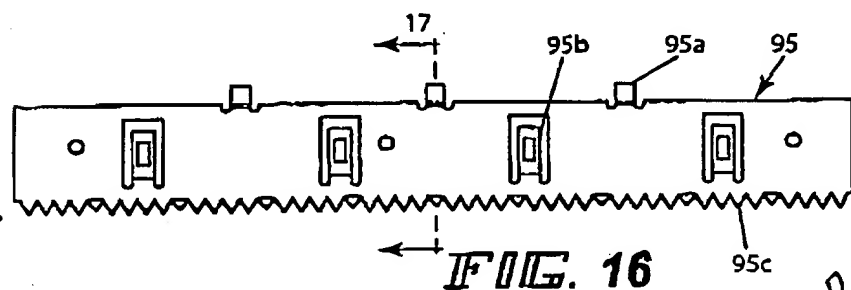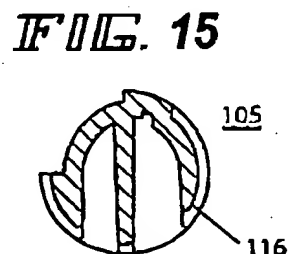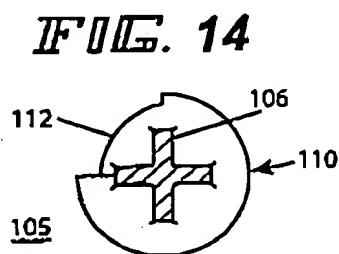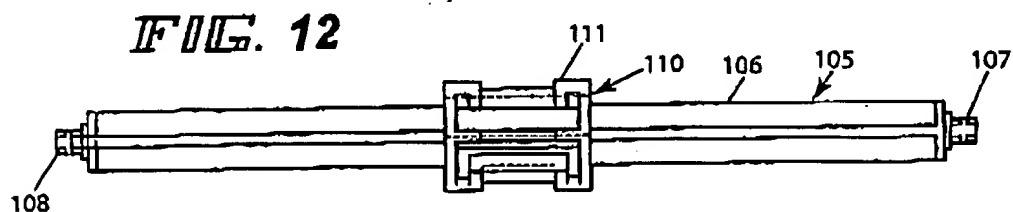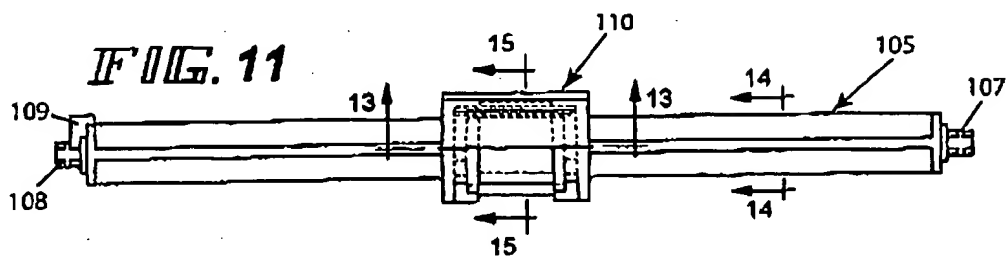

The Patent Office stamp placed hereon indicates receipt of:


Title: Multiple Roll Towel Dispenser
Applicant: LaCount et al.
Patent No.: 6,032,898
Issued: March 7, 2000
Attorney Docket No. ALW-113REX

Included are:

Transmittal Form
Revocation and Power of Attorney
Petition for Certificate of Correction
Proposed Certificate of Correction (9 pages)
Four (4) Sheets of Red-Lined Drawings
Return Postcard
Certificate of Mailing
Dated: October 17, 2008
JEM/cw

The Patent Office stamp placed hereon indicates receipt of:

Title: Multiple Roll Towel Dispenser
Applicant: LaCount et al.
Patent No.: 6,032,898
Issued: March 7, 2000
Attorney Docket No. ALW-113REX

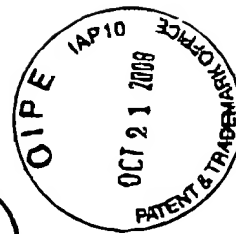

Included are:

Transmittal Form
Revocation and Power of Attorney
Petition for Certificate of Correction
Proposed Certificate of Correction (9 pages)
Four (4) Sheets of Red-Lined Drawings
Return Postcard
Certificate of Mailing
Dated: October 17, 2008
JEM/cw